



LEGEND		
SERVICE	DESCRIPTION	
	WATER MAIN	
	SANITARY SEWER	
	STORM SEWER	
	UNDERGROUND UTIL	
	PAVEMENT EDGE	
	FENCE	
	SWALE	
	DITCH	
	BUILDING	
WATER		END CAP
		CURB STOP
		HYDRANT
		LINE VALVE BLOW OFF WELL
SAN		END CAP
		MANHOLE CLEANOUT
STORM		END CAP
		CATCH BASIN (SIDE) CATCH BASIN (TOP) MANHOLE
UTILITIES		LAMP POLE
		UTILITY POLE
		POLE ANCHOR
		UTILITY MANHOLE UTILITY BOX
SURVEY		IRON PIN
		CONTROL POINT BENCHMARK OR MONUMENT

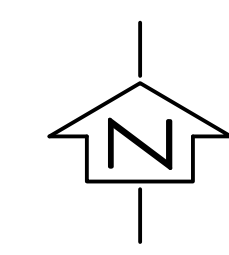

--- DENOTES ROAD OR DRIVEWAY

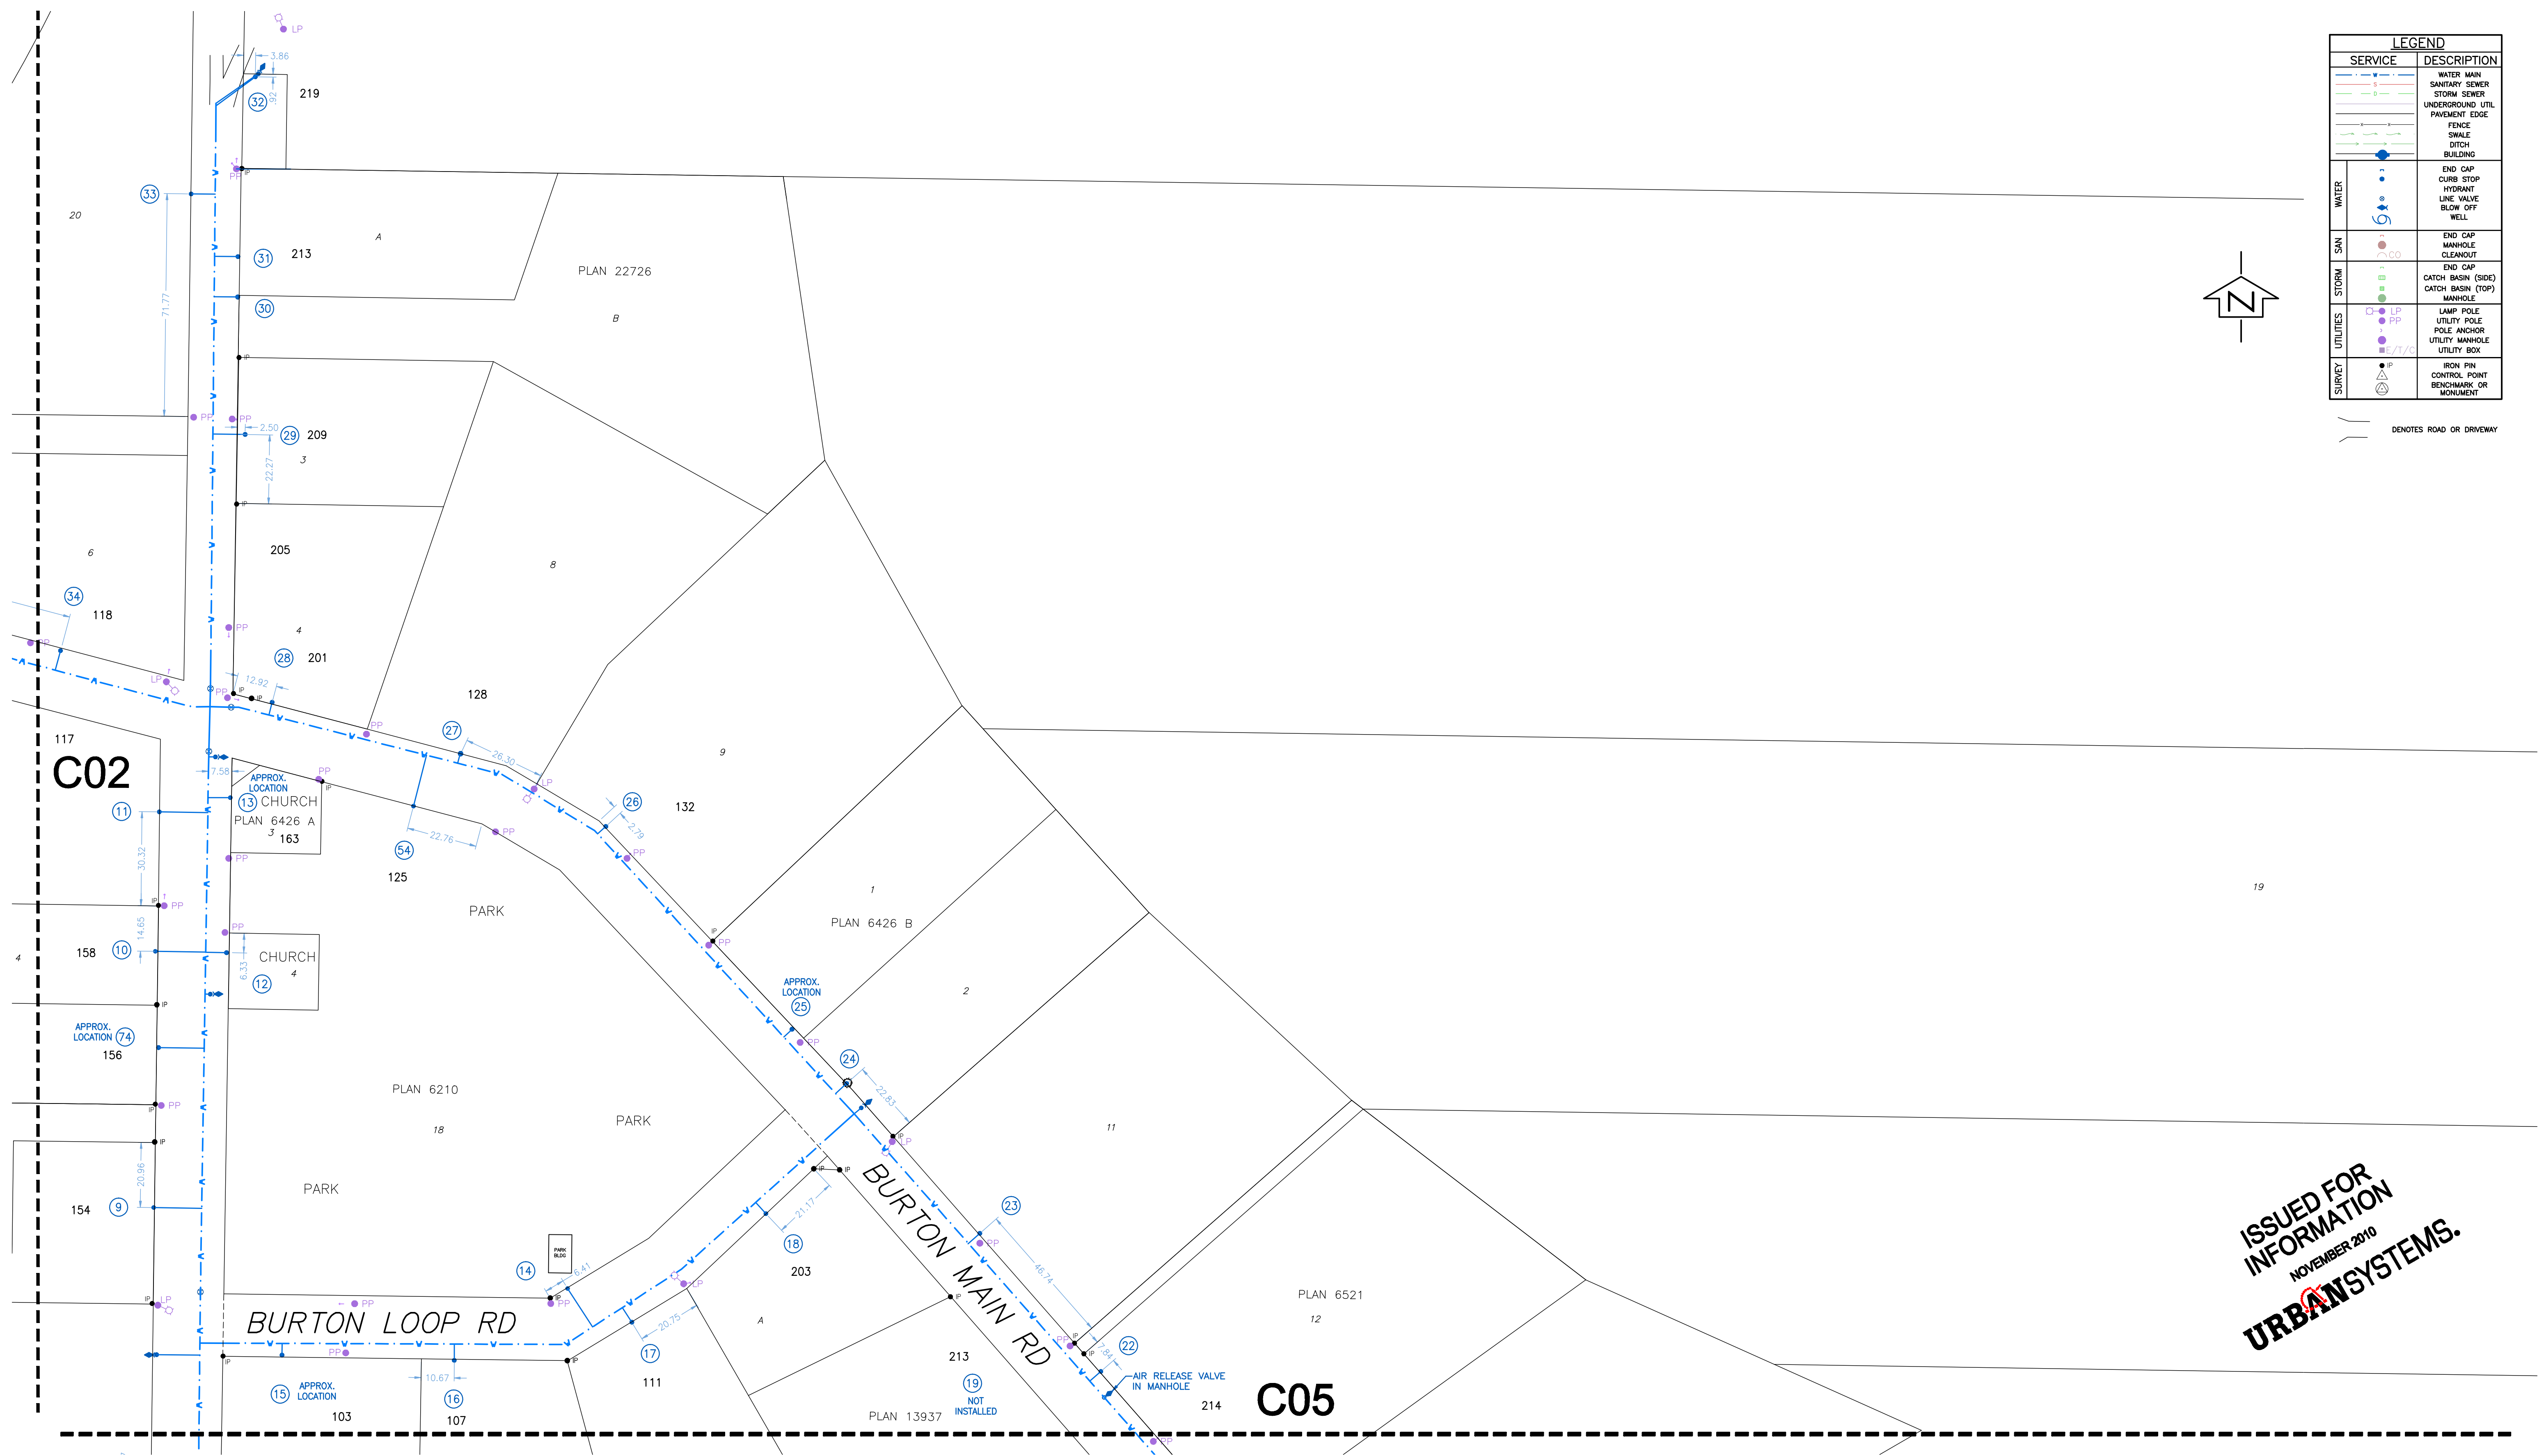

ISSUED FOR INFORMATION
NOVEMBER 2010
URBANSYSTEMS.

1:1000
0 10 20 30 40 50 METERS

U:\Projects_MEA\10760049\01\Drawings\Design_Analysis\CAD\DWG\BURTON\URBANSYSTEMS\COMP\SITE.dwg; C03_2010/04/20/09:12:15; pml\pmluser; 06 PM

No.	Date	By	Revision	Chk'd
3	2010/11/30	TP	UPDATED PER MARKUPS BY CP	PG
2	2010/05/31	TP	UPDATED PER MARKUPS BY CP	PG
1	2009/11/02	TP	ISSUED FOR INFORMATION	PG

URBANSYSTEMS.
304-1353 E 6th Street
Kelowna, BC V1Y 1Z9
Tel (250) 762-2517
Fax (250) 763-5266

Drawn:	TP
Design:	TP
Approved:	PG
Date:	2009-09-20
Scale:	1:1000

BC hydro

ARROW LAKES WATER SYSTEMS
BURTON WATER SYSTEM AND
UTILITIES INFORMATION
SHEET 2

File: 1076.0049.01	
Sheet 3 of 6	Revision Number
Drawing Number C03	3